



Massachusetts Department of Environmental Protection
Bureau of Resource Protection - Wetlands

WPA Form 8A – Request for Certificate of Compliance

Massachusetts Wetlands Protection Act M.G.L. c. 131, §40

DEP File Number:

49-571

Provided by DEP

A. Project Information

Important:

When filling out forms on the computer, use only the tab key to move your cursor - do not use the return key.



Upon completion of the work authorized in an Order of Conditions, the property owner must request a Certificate of Compliance from the issuing authority stating that the work or portion of the work has been satisfactorily completed.

1. This request is being made by:

Name Kevin Medeiros
Mailing Address 286 Union St.
City/Town New Bedford MA 02740 State MA Zip Code 02740
Phone Number 508-991-4040

2. This request is in reference to work regulated by a final Order of Conditions issued to:

Applicant Kevin Medeiros
Dated 5/1/06 DEP File Number 49-571

3. The project site is located at:

Street Address 24 Medeiros Court City/Town New Bedford
Assessors Map/Plat Number 136/457 Parcel/Lot Number 136/457 Lot #3

4. The final Order of Conditions was recorded at the Registry of Deeds for:

Property Owner (if different) Kevin Medeiros
County Bristol Book 8283 Page 137

Certificate (if registered land)

5. This request is for certification that (check one):

☒ the work regulated by the above-referenced Order of Conditions has been satisfactorily completed.

☐ the following portions of the work regulated by the above-referenced Order of Conditions have been satisfactorily completed (use additional paper if necessary).

☐ the above-referenced Order of Conditions has lapsed and is therefore no longer valid, and the work regulated by it was never started.



Massachusetts Department of Environmental Protection
Bureau of Resource Protection - Wetlands

DEP File Number:

WPA Form 8A – Request for Certificate of Compliance

Massachusetts Wetlands Protection Act M.G.L. c. 131, §40

Provided by DEP

A. Project Information (cont.)

6. Did the Order of Conditions for this project, or the portion of the project subject to this request, contain an approval of any plans stamped by a registered professional engineer, architect, landscape architect, or land surveyor?

☒ Yes

If yes, attach a written statement by such a professional certifying substantial compliance with the plans and describing what deviation, if any, exists from the plans approved in the Order.

☐ No

B. Submittal Requirements

Requests for Certificates of Compliance should be directed to the issuing authority that issued the final Order of Conditions (OOC). If the project received an OOC from the Conservation Commission, submit this request to that Commission. If the project was issued a Superseding Order of Conditions or was the subject of an Adjudicatory Hearing Final Decision, submit this request to the appropriate DEP Regional Office (see <http://www.mass.gov/eea/agencies/massdep/about/contacts/find-the-massdep-regional-office-for-your-city-or-town.html>).

136, LOT 61

MERIDIAN OF



DEFINITIVE SUBDIVISION PLAN IN
PLAN BOOK 155, PAGE 12

104.28'
N 29°04'11" W

ROOF INFILTRATION AREA

WETLANDS LINE

CONSERVATION SIGN

LOT 4
17,023 SQ. FT.
0.39 ACRES

EXISTING
DWELLING
23

DRIVEWAY

TRANSFORMER
CITY OF NB HAZARDOUS VOLT.

S 76°07'42" W
135.74'

EXISTING
DWELLING
24

EXISTING
DRIVEWAY

LOT 3
13,489 SQ. FT.
0.31 ACRES

CONSERVATION SIGN

ROOF INFILTRATION AREA

66.64'

FLARED END W/
RIP RAP
EL = 115.09

WETLANDS LINE

EMERGENCY SPILLWAY
ELEV = 116.5 +/-

S 85°58'33" W

FLARED END W/
RIP RAP
EL = 115.53

TOP OF FOREBAY
ELEV = 115.5 +/-

FLARED END W/
RIP RAP
EL = 115.57

MAP

L=75.00'

CB#1 (DOUBLE)

WG

HYDRANT

WG

DMH #1

EXISTING
DRIVEWAY

EXISTING
DWE
#

DETENTION
BASIN
BOT. EL = 115.0 +/-

RIP - RAP

DRAINAGE
EASEMENT
1,886 SQ. FT.

DRAINAGE
EASEMENT
3,143 SQ. FT.

47.39'

280.21'

4" DI

18

S 24°44'52" E

61.92'

117

116

115

-1

-2

MAP 136, LOT 15

MAP 136, LOT 61

SITE PLAN
SCALE: 1" = 20'

MAP 136, LOT 18

GENERAL NOTES:

REFER TO CITY OF NEW BEDFORD ASSESSORS MAP 136.

REFER TO PLAN BOOK 155, PAGE 12.

REFER TO PLAN BOOK 164, PAGE 34.

REFER TO PLAN BOOK 153, PAGE 65.

REFER TO PLAN OF ROAD IN THE CITY OF NEW BEDFORD, ACUSHNET AVENUE ALTERED AND LAID OUT BY THE CITY OF NEW BEDFORD, DECEMBER 2006, FILED IN PLAN BOOK 160, PAGE 29.

UNDERGROUND UTILITY LOCATIONS ARE APPROXIMATED BASED ON AN ON THE GROUND SURVEY AND INFORMATION SUPPLIED TO THIS OFFICE FROM MUNICIPAL DEPARTMENTS OWNER(DEVELOPER), AND/OR CONTRACTOR.

DEFINITIVE SUBDIVISION PLAN - MEDEIROS COURT - PREPARED BY SITEC, INC.

GAS AND ELECTRIC INFORMATION SHOWN IS APPROXIMATE AND NOT TO BE USED AS AS-BUILT LOCATIONS, CONTACT LOCAL GAS AND ELECTRIC COMPANY TO MARK OUT UTILIZING DIGSAFE MEASURES.


ALL SERVICE CONNECTIONS ARE APPROXIMATED AND NOT THE RESULT OF AN INSTRUMENT SURVEY.

MONUMENT SET ALONG ACUSHNET AVENUE BASED ON ALTERED ACUSHNET AVE. LAYOUT.

ALL CONCRETE BOUNDS WITH DRILL HOLES WERE SET IN ACCORDANCE WITH THE NORMAL STANDARD OF CARE OF A REGISTERED PROFESSIONAL LAND SURVEYOR PRACTICING IN THE COMMONWEALTH OF MASSACHUSETTS.

ROOF INFILTRATION/DRYWELL AS SHOWN BASED ON THE OWNERS LOCATION AND CONFIGURATION AND NOT THE RESULT OF AN AS-BUILT LOCATION BY THIS OFFICE.

- ELECTRIC BOX
- CABLE
- ☀ LIGHT POST
- GAS GATE
- TRANSFORMER
- ⊙ ELECTRIC MANHOLE
- 2" TREE
- ⊙ DRAIN MANHOLE
- ⊙ CATCH BASIN
- FIRE HYDRANT
- WATER GATE
- ⊙ SEWER MANHOLE
- CB/DH SET

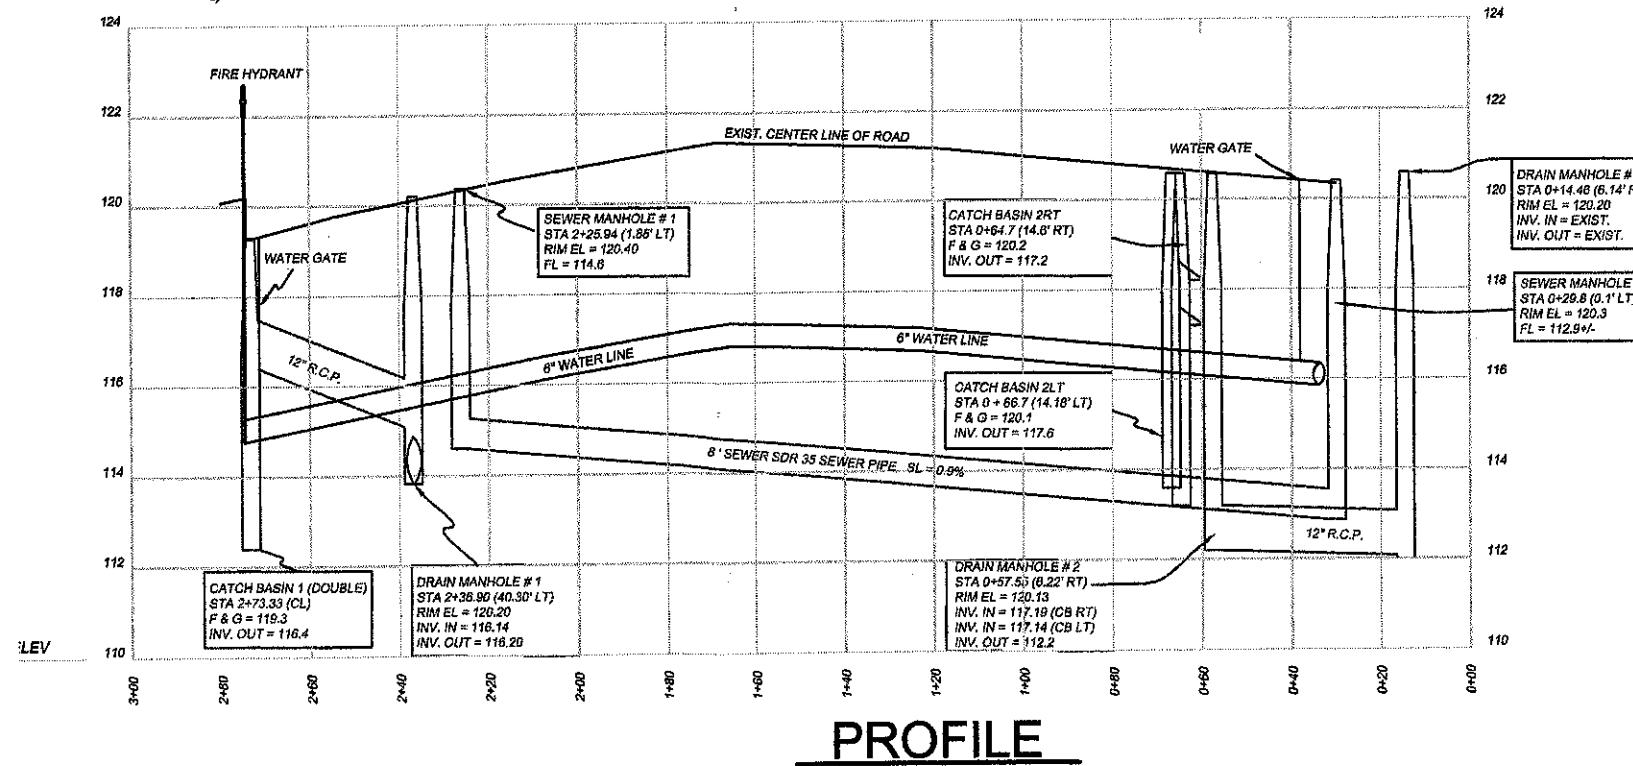

MEDEIROS COURT AS-BUILT PLAN

KEVIN MEDEIROS
MEDEIROS COURT
NEW BEDFORD, MA



KENNETH R. FERREIRA ENGINEERING, INC.
SUITE 2S, 46 FOSTER STREET
NEW BEDFORD, MASSACHUSETTS 02740
TEL: (508) 892-0020 - FAX: (508) 892-3374

DATE	REVISION	BY
11/04/03	PER CON. COMM. COMMENTS	KJS
DATE: 8-28-2008	DESIGNED BY:	
SCALE: 1" = 20'	CHECKED BY: KRF	
DRAWN BY: KJS	JOB No. SE 38449	